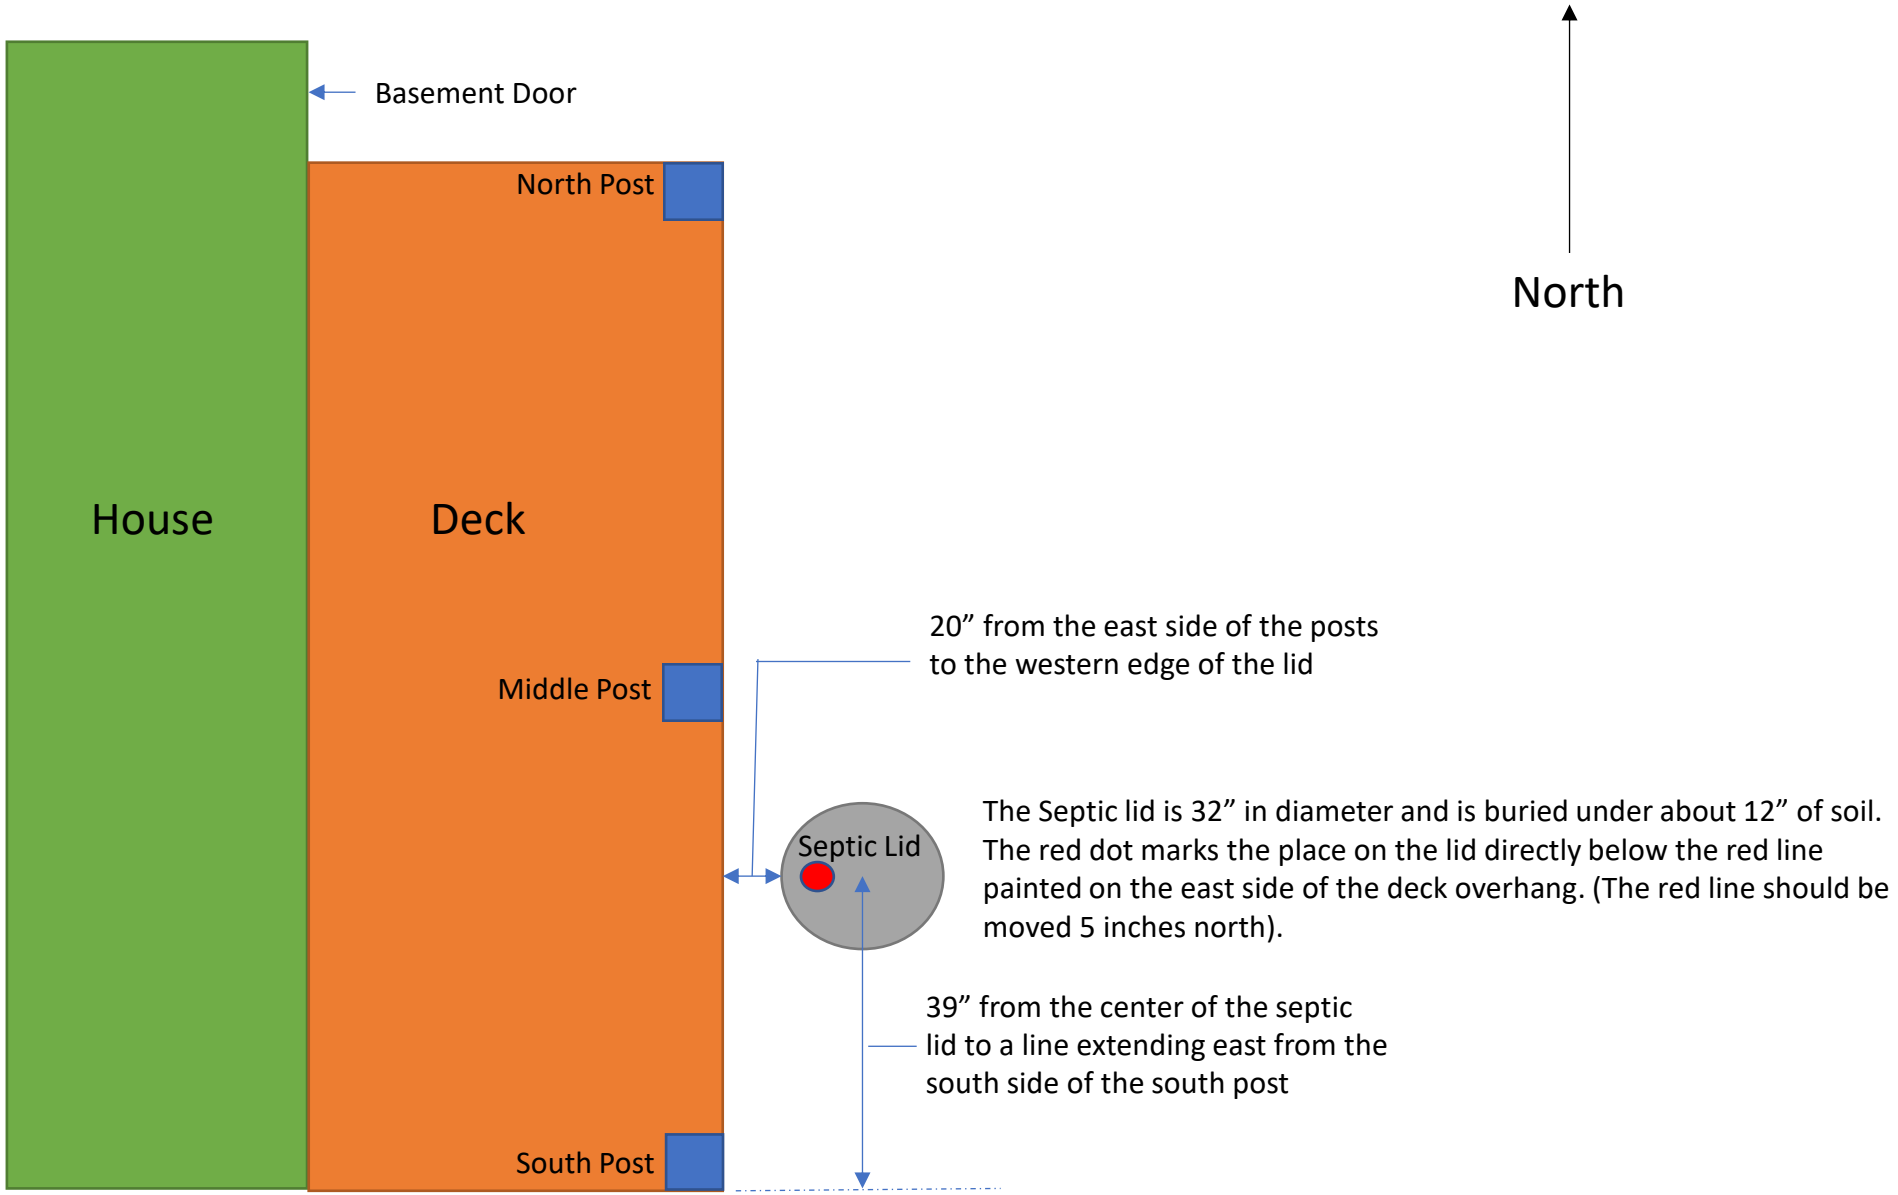
Basement Door
North Post
North
House
Deck
20” from the east side of the posts
to the western edge of the lid
Middle Post
Septic Lid
The Septic lid is 32” in diameter and is buried under about 12” of soil.
The red dot marks the place on the lid directly below the red line
painted on the east side of the deck overhang. (The red line should be
moved 5 inches north).
39” from the center of the septic
lid to a line extending east from the
south side of the south post
South Post